OP_STG

REVISION RECORD			
LTR	ECO NO:	APPROVED:	DATE:
	R454 to 0	05-07-12	GH
	R455 not used	05-07-12	GH
	R93 changed to 249R	8/2012	
	J4-J5 added to correct BOM		

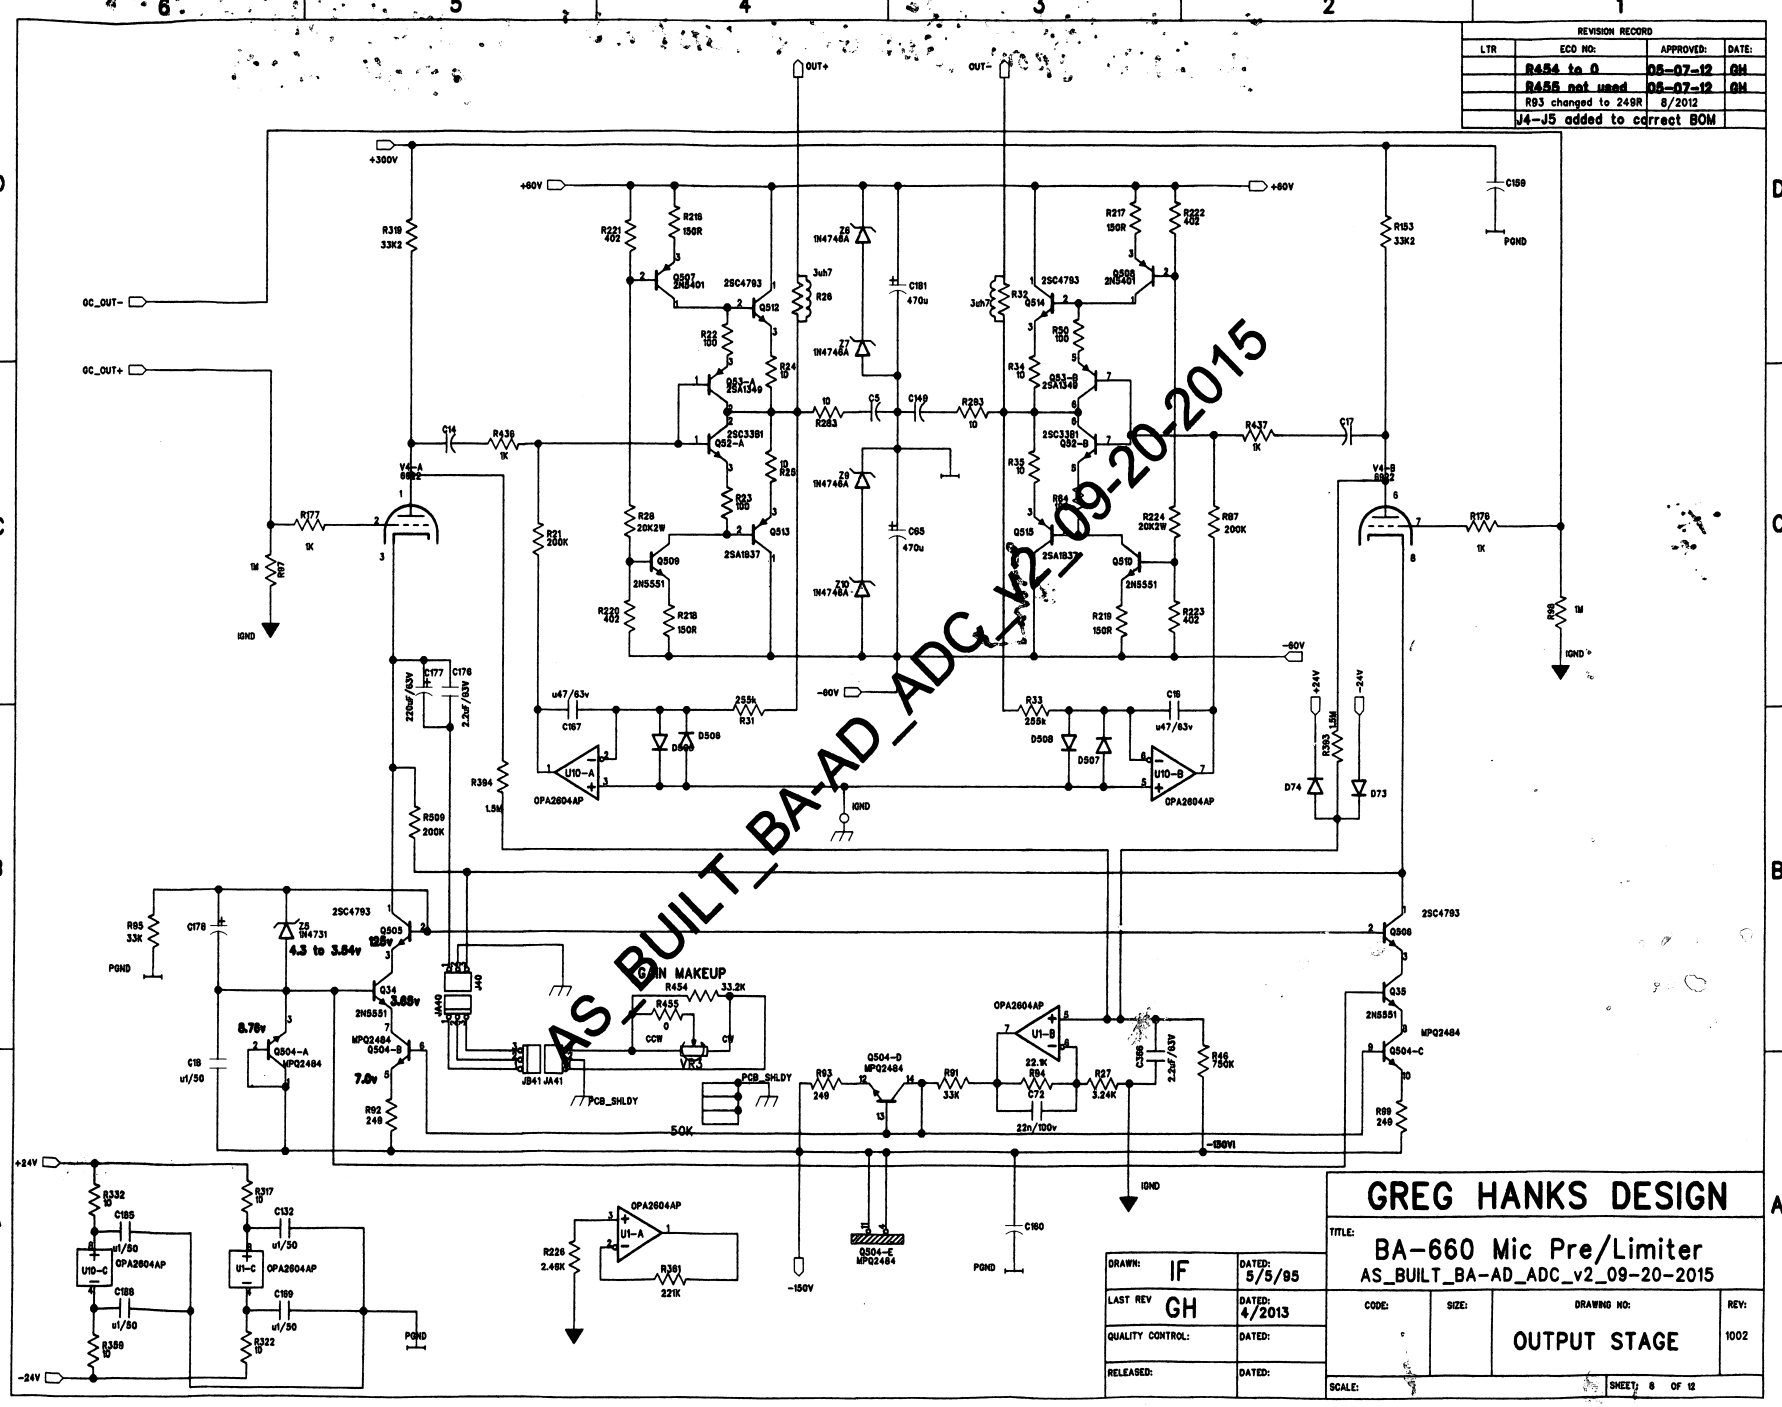

DRAWN:	IF	DATED:	5/5/95
LAST REV	GH	DATED:	4/2013
QUALITY CONTROL:		DATED:	
RELEASED:		DATED:	

GREG HANKS DESIGN

TITLE: BA-660 Mic Pre/Limiter
AS_BUILT_BA-AD_ADC_v2_09-20-2015

CODE:	SIZE:	DRAWING NO:	REV:
		OUTPUT STAGE	1002

SCALE: SHEET: 8 OF 12